


- NOTES**
1. ALL STRUCTURAL CONCRETE CLASS "J25" UNLESS NOTED OTHERWISE.
 2. ALL INTERIOR AND EXTERIOR CONCRETE SURFACES ARE PROTECTED BY A CORROSION RESISTANT EPOXY LINING EXCEPT EXTERIOR SURFACE ABOVE GRADE LEVEL WHICH IS TEXTURED WHITE FINISH OR OTHERWISE NOTED.
 3. ALL SLUICE GATES ARE SQUARE FRAMED WITH FLUSH BOTTOM CLOSURE SEE SPEC PART 14 SECTION 5.0 MAX. SEATING AND UNSEATING HEAD = 3M.
 4. FOR STRUCTURAL DETAILS SEE DWG. Nos. SD-314 & SD-315.

FINAL ACCEPTANCE AS BUILT
 Prepared by: *[Signature]*
 Checked by: *[Signature]*
 Project Engineer: *[Signature]*
 K.M.F. SALIM
 Contractor (Eng. Work)

AS-BUILT
 PREPARED BY ABUJULAH AL-BOSSARY & SONS
 CO. IN ASSOC. WITH A. H. AL-MUHANA EST.

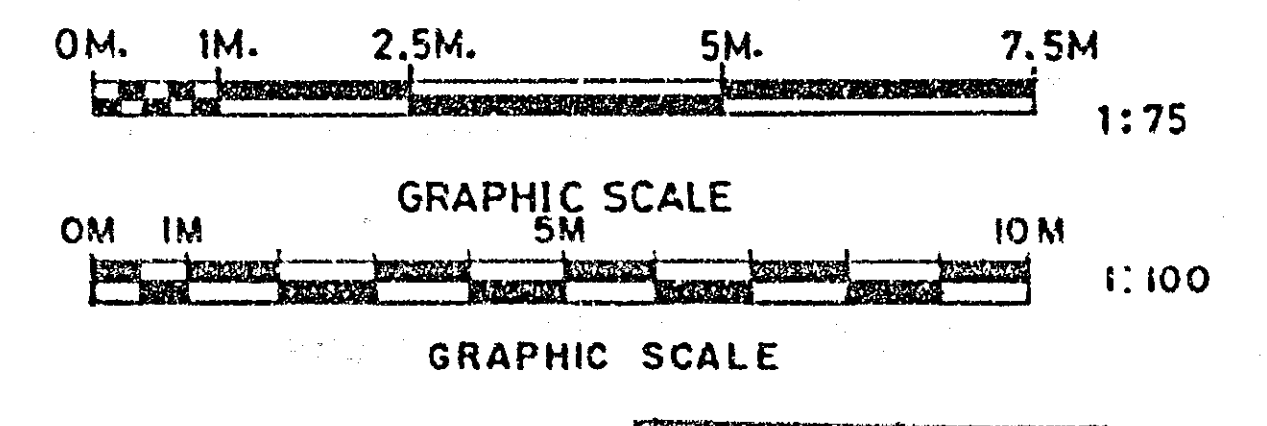

2 3/4 AS BUILT REVISION	REV B N.P.
AS BUILT	REV A M.P.
ISSUED FOR CONSTRUCTION	REV C M.P.
KINGDOM OF SAUDI ARABIA ROYAL COMMISSION FOR JUBAIL & YANBU DIRECTORATE GENERAL FOR MADINAT AL-JUBAIL AL-SINAIYAH	
AL RAHBI TECHN. WORKS	الرائي التكنيكي
570-T01	٥٧٠ - ت ٠١
WASTE WATER PUMP STATION P-3 STAGE-1	مرحلة الاولى من محطة رفع مياه المجاري - ٣
FLOW DIVIDING CHAMBER	حجرة قواسم التدفق (الاصناف) 09 OCT 1993 JUBAIL ENGINEERING
FACILITY No. 1-60-581	٥٨١ - ٦٠ - ١
CONTRACT No. 581-C20	رقم العقد ٥٨١ - ٢٠ - ٢٠
SCALE: AS SHOWN	DRIVING No. 581-340-20CS - MD-410
AS SHOWN	2

MICROBOX